C1.35
SHEET 15 OF 40

2016-007A
Roadway Striping & Signage Plan – Area E
Main Street Streetscape

T.L. 23/30
W. &
H. Oberg
in Street
ME 04009

T.L. 23/31
Orchard View LLC
154 Main Street
Bridgton, ME 04009

T.L. 23/32
Mark W. &
Sonya A. Allen
PO Box 283
Bridgton, ME 04009

T.L. 23/33
Kermit G. &
Esther H. Foster
PO Box 519
Naples, ME 04055

T.L. 23/34
Chung Yang, Inc.
PO Box 1053
Bridgton, ME 04009

T.L. 23/54
Charles J. &
Jayne L. Hamaty
PO Box 154
N. Bridgton, ME 04057

T.L. 23/55
People's Heritage Bank
380 Wellington Street
London, Ontario N6A 454

T.L. 23/57
Andrew Lowell
117 Lee Gray Road
Sweden, ME 04040

T.L. 23/58
Leslie &
Debora J. Kutasi
196 Main Street
Bridgton, ME 04009

T.L. 23/128
Ren–Bro Inc
731 Route 1
Newcastle, ME 04553

T.L. 23/126
Ren–Bro Inc
731 Route 1
Newcastle, ME 04553

T.L. 23/125
Ren–Bro Inc
731 Route 1
Newcastle, ME 04553

T.L. 23/124
N.C.M.H Guild
PO Box 230
Bridgton, ME 04009

T.L. 23/123
Mark H. Grenda
PO Box 362
Bridgton, ME 04009

T.L. 23/122
Peter H. &
Patricia E. Duburle
PO Box 545
Bridgton, ME 04009

T.L. 23/121
Craig E. &
Jane E. Jud
191 Main Street
Bridgton, ME 04009

T.L. 23/120
James L. &
Marilyn B Thompson
35 Edes Falls Road
Naples, ME 04055

ELM STREET
MAIN STREET
DEPOT STREET
U.S. ROUTE

CONSTRUCT (10) PARALLEL PARKING SPACES. (4SSLW)
CONSTRUCT (3) PARALLEL PARKING SPACES. (4SSLW)
CONSTRUCT (4) PARALLEL PARKING SPACES. (4SSLW)
RELOCATE EXISTING "DO NOT ENTER" SIGN.
CONSTRUCT 8' WIDE SPECIAL CROSSWALK.
NO PARKING
YIELD
4SSLW
4DSLY
18SL
MATCH TO SHEET C1.36
SEE INSET BELOW

EXISTING CURBING AND STRIPING IS SHOWN IN RED

13.0' 12.7' 41.7' 39.7' 12.5' 11.4'
13.0' 12.0' 41.6' 39.6' 12.6' 11.4'
8.0' TYP
20.0' 22.0' 20.0'
11.0' 20.0' 22.2' 20.1'
5.0'

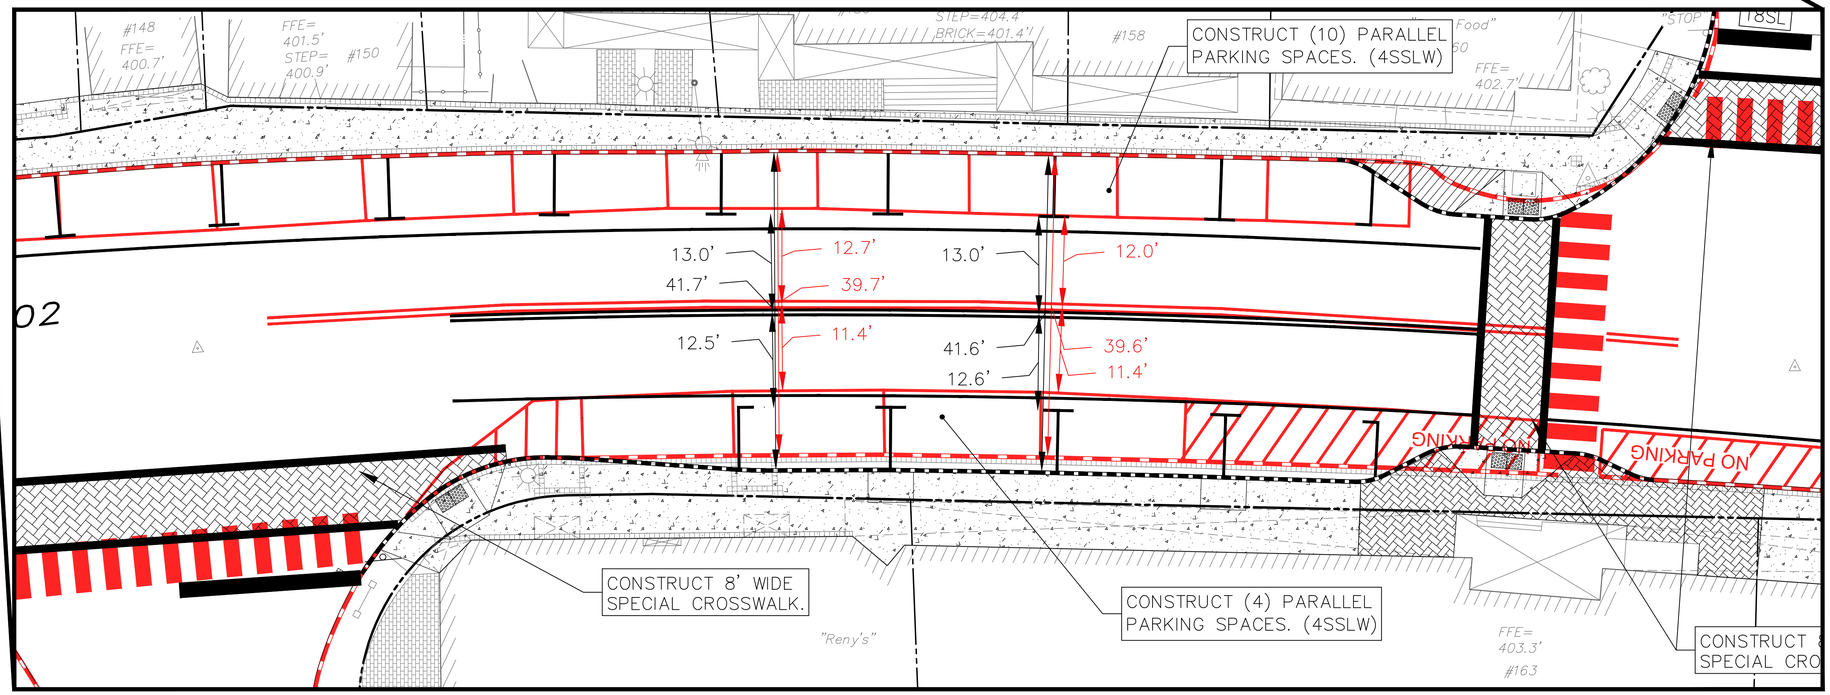


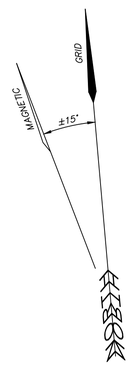


20 0 20 40 80 ft
4 0 10 20 m
1 inch = 20 feet
( 1 : 240 )

| Copyright | 2018 | HEB Engineers, Inc. | |
|---|---|---|---|
| | | | |
| | | | |
| | | | |
| | | | |
| | | | |
| No. | Revision | DATE | BY |

HEB Engineers
CIVIL • STRUCTURAL • SURVEY


HEB Engineers, Inc.
www.hebengineers.com
NH Office (603) 356-6936
Post Office Box 440
North Conway, NH 03860
ME Office (207) 803-8265
Post Office Box 343
Bridgton, ME 04009


| | |
|---|---|
| SURVEYED BY | JLT/MPM |
| DESIGNED BY | TCD |
| DRAWN BY | TCD |
| CHECKED BY | JMM |
| FIELD BOOK | 353 |
| SCALE | 1"=20' |
| DATE | 10/22/2018 |

Roadway Striping & Signage Plan – Area E
for the
PRELIMINARY NOT FOR CONSTRUCTION
Main Street Streetscape
located in and prepared for the
Town of Bridgton, Maine

2016-007A
C1.35
SHEET 15 OF 40

Q:\Jobs\2016\2016-007A T.O. Bridgton - Main Street Streetscape - Phase II, Bridgton, ME\Dwg\Temp\Plans-Roadway Width Exhibit.dwg, C1.35, 10/26/2018 8:26:51 AM, cdinsmore